


GENERAL NOTES:

1. ALL WORKS TO COMPLY WITH SANDY CITY STANDARDS AND SPECIFICATIONS.
2. ALL IMPROVEMENTS SHALL ADHERE TO ADA STANDARDS AND RECOMMENDATIONS.
3. DIMENSIONS ARE TO BACK OF CURB U.N.O.
4. CONTRACTOR SHALL REPAIR CURB, GUTTER, AND SIDEWALK ON THE SSID PROPERTY WHERE TYING IN NEW CONSTRUCTION.

KEYNOTES:


1. 6" CONCRETE CURB WALL, PER DETAIL 1/C-006 (SANDY CITY DETAIL CG-01).
2. 30" CONCRETE STANDARD CURB AND GUTTER, PER DETAIL 1/C-006 (SANDY CITY DETAIL CG-01).
3. CONCRETE WATERWAY PER DETAIL 3/C-006 (SANDY CITY DETAIL CG-03).
4. COMMERCIAL DRIVE APPROACH PER DETAIL 4/C-006 (SANDY CITY DETAIL DA-03).
5. 5' CONCRETE SIDEWALK, SEE DETAIL 4/C-009.
6. ADA COMPLIANT DETECTABLE WARNING SURFACE PER DETAIL 3/C-009, SAFETY YELLOW, CAST IN CONCRETE, FULL WIDTH OF RAMP.
7. 4" SOLID WHITE STRIPING.
8. 4" DASHED WHITE STRIPING.
9. PROPERTY BOUNDARY.
10. RELOCATE EXISTING LIGHTING APPROXIMATELY 7' SOUTH OF CURRENT LOCATION.
11. FILL WITH CONCRETE BETWEEN CURBING.
12. DIESEL FUELING STATION, EQUIPMENT AND TANK PROVIDED BY OWNER AND INSTALLED BY CONTRACTOR.
13. DUAL HEAD ELECTRIC CHARGING STATIONS, REF. ELECTRICAL DWGS.
14. CONCRETE GENERATOR PAD, SEE DETAIL 7/C-005. LOCATE PAD TO MAINTAIN REQUIRED CLEARANCE PER MANUFACTURER'S RECOMMENDATIONS.
15. CONCRETE TRANSFORMER PAD, SEE DETAIL 5/C-005. LOCATE PAD TO MAINTAIN REQUIRED CLEARANCE PER MANUFACTURER'S RECOMMENDATIONS.
16. 40' LONG x 6' TALL ELECTRIC OPERATED DOUBLE (20' EACH SIDE) SWING GATE, AMERISTAR TRANSPORT II, OR APPROVED EQUAL. USE LIFTMASTER HDSW24UL OPERATOR WITH ALL COMPONENTS NECESSARY FOR A COMPLETE AND OPERABLE SYSTEM, OR APPROVED EQUAL.
17. GATE OPERATOR, MOUNT @ 42" AFG ON GOOSENECK STAND.
18. 16' LONG 6' TALL MANUAL SWING GATE, AMERISTAR MONTAGE II OR APPROVED EQUAL. (COORDINATE GATE LOCATION WITH OWNER) AND 4' PEDESTRIAN GATE, DETAIL 5/C-010 (LOCATE ADJACENT TO BUILDING). INCLUDE GATE LOCKS.
19. ALL EXTERIOR GATES SHALL INCLUDE SANDY CITY APPROVED KNOX BOX FOR FIRE ACCESS, PER SANDY CITY STANDARDS.
20. 60"x10' FAIRBANKS SCALE PROVIDED BY OWNER, INSTALLED BY SUPPLIER. CONTRACTOR SHALL INSTALL CONCRETE PIT PER SUPPLIERS RECOMMENDATIONS AND DETAILS. SEE DETAIL 1, SHEET C-102.
21. 50"x10' FAIRBANKS SCALE PROVIDED BY OWNER, INSTALLED BY SUPPLIER. CONTRACTOR SHALL INSTALL CONCRETE PIT PER SUPPLIERS RECOMMENDATIONS AND DETAILS. SEE DETAIL 2, SHEET C-102.
22. 6' PRECAST CONCRETE WALL, OLYMPUS PRECAST STANDARD SHIPLAP OR APPROVED EQUAL.
23. RECYCLING CANOPY, SEE STRUCTURAL DETAILS.
24. 6' ORNAMENTAL STEEL FENCING, USE AMERISTAR MONTAGE II OR APPROVED EQUAL WITH THE FOLLOWING INCLUDED: CLASSIC STYLE TOP, 8" PANEL LENGTHS, 3-RAIL PANELS WITH 4" AIR GAP, STANDARD SQUARE POSTS WITH FLAT CAPS, POST AND HARDWARE AS REQUIRED BY MANUFACTURER.
25. CAST-IN-PLACE RETAINING WALL, PER DETAIL 8/S-001.
26. 20' LONG 6' TALL MANUAL DOUBLE SWING GATE, AMERISTAR MONTAGE II OR APPROVED EQUAL. INCLUDE HARDWARE AND LOCKS.
27. 25' LONG 6' TALL MANUAL SWING GATE, AMERISTAR MONTAGE II OR APPROVED EQUAL.
28. 32' LONG 6' TALL MANUAL DOUBLE SWING GATE, AMERISTAR MONTAGE II OR APPROVED EQUAL.
29. 36' LONG 6' TALL ELECTRIC OPERATED CANTILEVERED GATE, AMERISTAR TRANSPORT II OR EQUIVALENT. USE LIFTMASTER INSL24UL OPERATOR WITH ALL COMPONENTS NECESSARY FOR A COMPLETE AND OPERABLE SYSTEM, OR APPROVED EQUAL.
30. 26' LONG 6' TALL ELECTRIC OPERATED SWING GATE, AMERISTAR TRANSPORT II OR EQUIVALENT. USE LIFTMASTER INSL24UL OPERATOR WITH ALL COMPONENTS NECESSARY FOR A COMPLETE AND OPERABLE SYSTEM, OR APPROVED EQUAL.
31. 4' WIDE 6' TALL MANUAL PEDESTRIAN GATE, AMERISTAR MONTAGE II OR APPROVED EQUAL. INCLUDE HARDWARE AND GATE LOCK.
32. ROLLUP DOOR SENSOR IN DRIVEWAY. INSTALL PER MANUFACTURER'S RECOMMENDATIONS.
33. PAINT STOP BAR.
34. OUTBOUND GATE DOOR SENSOR PER MANUFACTURER'S RECOMMENDATIONS.
35. 20'x60' CLEAR-VIEW TRIANGLE. NO OBSTACLES (INCLUDING VEGETATION) OVER THREE FEET HIGH, AS MEASURED FROM TOP BACK OF CURB, ARE ALLOWED WITHIN THE TRIANGLE.
36. 8' PRECAST CONCRETE WALL, OLYMPUS PRECAST STANDARD SHIPLAP OR APPROVED EQUAL.
37. REMOVE AND RELOCATE STREETLIGHT SOUTH TO THE PARK STRIP. CONTRACTOR MAY REUSE THE FIXTURE IF NOT DAMAGED. PROVIDE NEW BASE, POLE, CONDUITS, WIRES, ETC. PER SANDY CITY STANDARDS.
38. UNATTENDED SCALE KIOSK, PROVIDED BY SOFTWARE SUPPLIER, INSTALLED BY CONTRACTOR. MOUNT KIOSK ON 4" SQUARE SHAPED STEEL POLE 10' TALL. MOUNTING HEIGHT SHALL BE FIELD COORDINATED WITH ENGINEER AND OWNER. LOCATE 12-FEET FROM FRONT OF SCALE AND 2-FEET FROM EDGE OF SCALE. PROVIDE (1) POWER CONDUIT TO ELECTRICAL SOURCE AND (1) COMMUNICATION CONDUIT FROM THE BUILDING NETWORK, WITH PULL STRINGS.
39. FURNISH AND INSTALL 36-50 IN GROUND LOOP SENSOR, CONNECT TO GATE CABINET.
40. LIFTMASTER VEHICLE ACCESS GATE, PROVIDED BY SOFTWARE SUPPLIER, INSTALLED BY CONTRACTOR. PROVIDE (1) POWER CONDUIT TO ELECTRICAL SOURCE AND (1) COMMUNICATION CONDUIT TO THE OPTO BOX WITH PULL STRINGS.
41. PHOTO EYES FOR VEHICLE ACCESS GATES, PROVIDED BY GATE SUPPLIER, INSTALLED BY CONTRACTOR. PROVIDE COMMUNICATION CONDUIT WITH PULL STRING FROM PHOTO EYE TO THE GATE CABINET. LOCATION PER THE SITE PLAN CAD FILE.
42. INSTALL REFLECTOR DIRECTLY ACROSS FROM THE PHOTO EYE, MOUNTED TO CONCRETE BOLLARD PER ARCHITECTURAL DETAIL.
43. OPTO BOX FOR ACCESS GATES, PROVIDED BY PARADIGM, INSTALLED BY CONTRACTOR. RUN POWER IN SAME CONDUIT AS KIOSK FROM THE POWER SOURCE. CONNECT TO NETWORK IN THE KIOSK WITH A NETWORK SWITCH. PROVIDE (1) CONDUIT TO ACCESS GATES FOR COMMUNICATIONS, WITH PULL STRINGS.
44. BOLLARDS PER ARCHITECTURAL DETAILS.

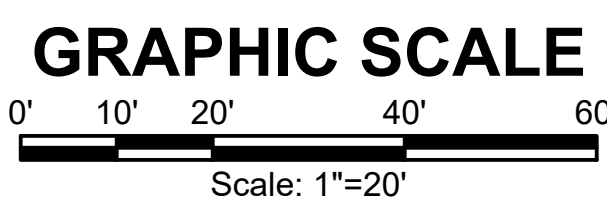

PERMIT SET

| CONSTRUCTION DOCUMENTS | |
|------------------------|-------------------|
| DATE | REVISION |
| 1/6/22 | ADDENDUM 5 |
| 2/8/23 | SITE PLAN REVIEW |
| 3/17/23 | SITE PLAN UPDATES |
| 5/15/23 | PR 002 |
| 6/23/23 | PR 002 |
| 7/10/24 | SCALE UPDATES |

F:\S:\Cadd\Structure\2021\05-21-0172 Trans-Jordan Waste Transfer Station\CAD\Sheet\05-21-0172 C-101.dwg ----- 9/23/2024 4:27 PM

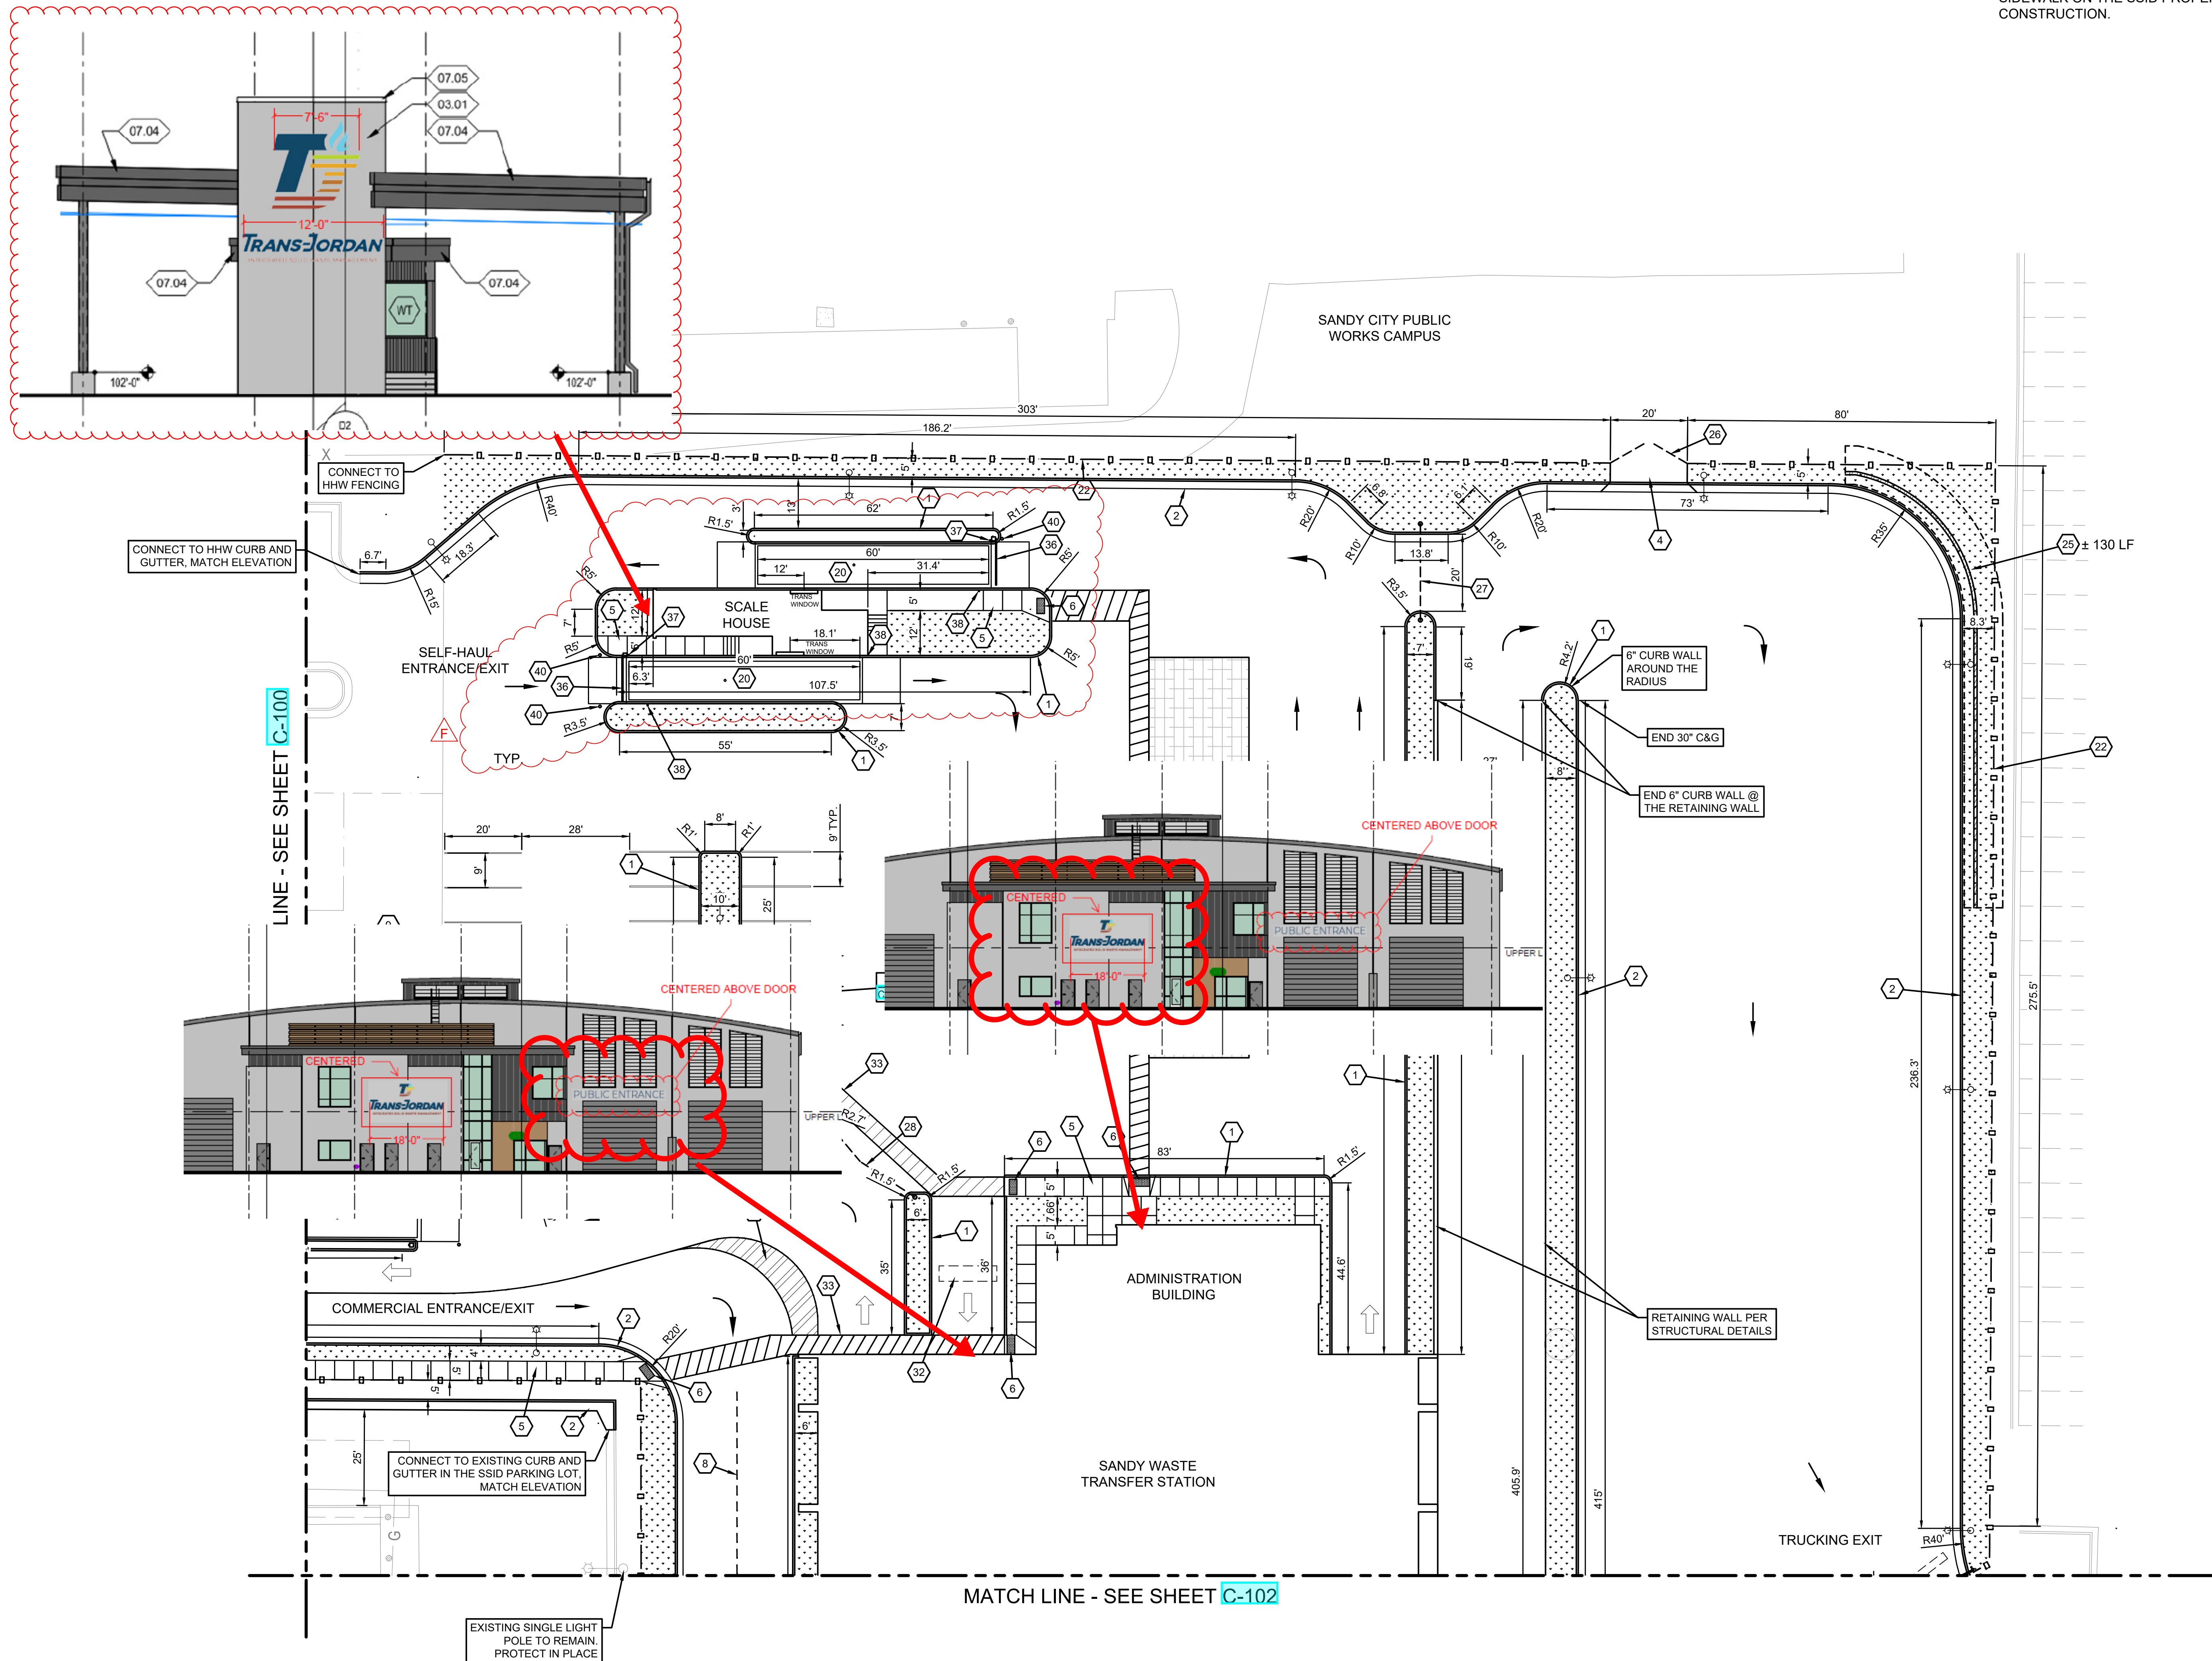

AREA 2 - SITE PLAN
SCALE: 1"=20'

GENERAL NOTES:


1. ALL WORKS TO COMPLY WITH SANDY CITY STANDARDS AND SPECIFICATIONS.
2. ALL IMPROVEMENTS SHALL ADHERE TO ADA STANDARDS AND RECOMMENDATIONS.
3. DIMENSIONS ARE TO BACK OF CURB U.N.O.
4. CONTRACTOR SHALL REPAIR CURB, GUTTER, AND SIDEWALK ON THE SSID PROPERTY WHERE TYING IN NEW CONSTRUCTION.

KEYNOTES:

1. 6" CONCRETE CURB WALL, PER DETAIL 1/C-006 (SANDY CITY DETAIL CG-01).
2. 30" CONCRETE STANDARD CURB AND GUTTER, PER DETAIL 1/C-006 (SANDY CITY DETAIL CG-01).
3. CONCRETE WATERWAY PER DETAIL 3/C-006 (SANDY CITY DETAIL CG-03).
4. COMMERCIAL DRIVE APPROACH PER DETAIL 4/C-006 (SANDY CITY DETAIL DA-03).
5. 5" CONCRETE SIDEWALK, SEE DETAIL 4/C-009.
6. ADA COMPLIANT DETECTABLE WARNING SURFACE PER DETAIL 3/C-009, SAFETY YELLOW, CAST IN CONCRETE, FULL WIDTH OF RAMP.
7. 4" SOLID WHITE STRIPING.
8. 4" DASHED WHITE STRIPING.
9. PROPERTY BOUNDARY.
10. RELOCATE EXISTING LIGHTING APPROXIMATELY 7' SOUTH OF CURRENT LOCATION.
11. FILL WITH CONCRETE BETWEEN CURBING.
12. DIESEL FUELING STATION, EQUIPMENT AND TANK PROVIDED BY OWNER AND INSTALLED BY CONTRACTOR.
13. DUAL HEAD ELECTRIC CHARGING STATIONS, REF. ELECTRICAL DWGS.
14. CONCRETE GENERATOR PAD, SEE DETAIL 7/C-005. LOCATE PAD TO MAINTAIN REQUIRED CLEARANCE PER MANUFACTURER'S RECOMMENDATIONS.
15. CONCRETE TRANSFORMER PAD, SEE DETAIL 5/C-005. LOCATE PAD TO MAINTAIN REQUIRED CLEARANCE PER MANUFACTURER'S RECOMMENDATIONS.
16. 40' LONG x 6' TALL ELECTRIC OPERATED DOUBLE (20' EACH SIDE) SWING GATE, AMERISTAR TRANSPORT II, OR APPROVED EQUAL. USE LIFTMASTER HDSW24UL OPERATOR WITH ALL COMPONENTS NECESSARY FOR A COMPLETE AND OPERABLE SYSTEM, OR APPROVED EQUAL.
17. GATE OPERATOR, MOUNT @ 42" AFG ON GOOSENECK STAND.
18. 16' LONG 6' TALL MANUAL SWING GATE, AMERISTAR MONTAGE II OR APPROVED EQUAL. (COORDINATE GATE LOCATION WITH OWNER) AND 4' PEDESTRIAN GATE, DETAIL 8/C-010 (LOCATE ADJACENT TO BUILDING). INCLUDE GATE LOCKS.
19. ALL EXTERIOR GATES SHALL INCLUDE SANDY CITY APPROVED KNOX BOX FOR FIRE ACCESS, PER SANDY CITY STANDARDS.
20. 80'x10' FAIRBANKS SCALE PROVIDED BY OWNER. INSTALLED BY SUPPLIER. CONTRACTOR SHALL INSTALL CONCRETE PIT PER SUPPLIERS RECOMMENDATIONS AND DETAILS. SEE DETAIL 1, SHEET C-102.
21. 50'x10' FAIRBANKS SCALE PROVIDED BY OWNER. INSTALLED BY SUPPLIER. CONTRACTOR SHALL INSTALL CONCRETE PIT PER SUPPLIERS RECOMMENDATIONS AND DETAILS. SEE DETAIL 2, SHEET C-102.
22. 6' PRECAST CONCRETE WALL, OLYMPUS PRECAST STANDARD SHIPLAP OR APPROVED EQUAL.
23. RECYCLING CANOPY. SEE STRUCTURAL DETAILS.
24. 6' ORNAMENTAL STEEL FENCING. USE AMERISTAR MONTAGE II OR APPROVED EQUAL WITH THE FOLLOWING INCLUDED: CLASSIC STYLE TOP, 8' PANEL LENGTHS, 3-RAIL PANELS WITH 4" AIR GAP, STANDARD SQUARE POSTS WITH FLAT CAPS, POST AND HARDWARE AS REQUIRED BY MANUFACTURER.
25. CAST-IN-PLACE RETAINING WALL PER DETAIL 8/SE-01.
26. 20' LONG 6' TALL MANUAL DOUBLE SWING GATE, AMERISTAR MONTAGE II OR APPROVED EQUAL. INCLUDE HARDWARE AND LOCKS.
27. 25' LONG 6' TALL MANUAL SWING GATE, AMERISTAR MONTAGE II OR APPROVED EQUAL.
28. 32' LONG 6' TALL MANUAL DOUBLE SWING GATE, AMERISTAR MONTAGE II OR APPROVED EQUAL.
29. 36' LONG 6' TALL ELECTRIC OPERATED CANTILEVERED GATE, AMERISTAR TRANSPORT II OR EQUIVALENT. USE LIFTMASTER INSL24UL OPERATOR WITH ALL COMPONENTS NECESSARY FOR A COMPLETE AND OPERABLE SYSTEM, OR APPROVED EQUAL.
30. 26' LONG 6' TALL ELECTRIC OPERATED SWING GATE, AMERISTAR TRANSPORT II OR EQUIVALENT. USE LIFTMASTER INSL24UL OPERATOR WITH ALL COMPONENTS NECESSARY FOR A COMPLETE AND OPERABLE SYSTEM, OR APPROVED EQUAL.
31. 4' WIDE 6' TALL MANUAL PEDESTRIAN GATE, AMERISTAR MONTAGE II OR APPROVED EQUAL. INCLUDE HARDWARE AND GATE LOCK.
32. ROLLUP DOOR SENSOR IN DRIVEWAY. INSTALL PER MANUFACTURER'S RECOMMENDATIONS.
33. PAINT 5' WIDE CROSSWALK.
34. OUTBOUND GATE DOOR SENSOR PER MANUFACTURER'S RECOMMENDATIONS.
35. FURNISH AND INSTALL 36-50 IN GROUND LOOP SENSOR, CONNECT TO GATE CABINET.
36. LIFTMASTER VEHICLE ACCESS GATE, PROVIDED BY SOFTWARE SUPPLIER, INSTALLED BY CONTRACTOR. PROVIDE (1) POWER CONDUIT TO ELECTRICAL SOURCE AND (1) COMMUNICATION CONDUIT TO THE OPTO BOX WITH PULL STRINGS.
37. PHOTO EYES FOR VEHICLE ACCESS GATES, PROVIDED BY GATE SUPPLIER, INSTALLED BY CONTRACTOR. PROVIDE COMMUNICATION CONDUIT WITH PULL STRING FROM PHOTO EYE TO THE GATE CABINET. LOCATION PER THE SITE PLAN CAD FILE.
38. INSTALL REFLECTOR DIRECTLY ACROSS FROM THE PHOTO EYE, MOUNTED TO CONCRETE BOLLARD PER ARCHITECTURAL DETAIL.
39. OPTO BOX FOR ACCESS GATES, PROVIDED BY PARADIGM, INSTALLED BY CONTRACTOR. RUN POWER IN SAME CONDUIT AS GATES FROM THE SCALE BUILDING. PROVIDE (1) CONDUIT TO SERVER ROOM IN SCALE BUILDING. PROVIDE (1) CONDUIT TO ACCESS GATES FOR COMMUNICATIONS, WITH PULL STRINGS.
40. BOLLARDS PER ARCHITECTURAL DETAILS.



GRAPHIC SCALE

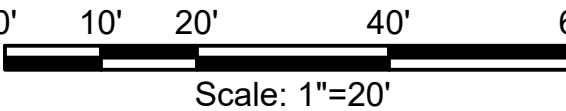

PERMIT SET

Galloway

577 South 200 East
Ogden, UT 84203
Call: 801.333.2100
GallowayUS.com

FORSGREN
Associates, Inc.
200 East 500 South, STE 200, OGDEN, UT 84203
PH: 801.364.4785 FAX: 801.364.4802

TRANS-JORDAN: SANDY WASTE TRANSFER STATION

8854 SOUTH PARKLAND DRIVE
SANDY, UT 84070

FA PROJECT # 05-21-0172

PROJECT # 05-21-0172


CONSTRUCTION DOCUMENTS

| DATE | REVISION |
|---------|---------------|
| 1/6/22 | ADDENDUM 5 |
| 5/15/23 | PROJ2 |
| 6/21/23 | PROJ2 |
| 7/10/24 | SCALE UPDATES |
| 8/26/24 | SCALE UPDATES |

SITE PLAN
AREA 2

C-101

F:\SLC\Drawings\Structure\2021\05-21-0172 Trans-Jordan Waste Transfer Station\CAD Sheets\Civil\05-21-0172 C-102.dwg ----- 1/24/2025 2:05 PM

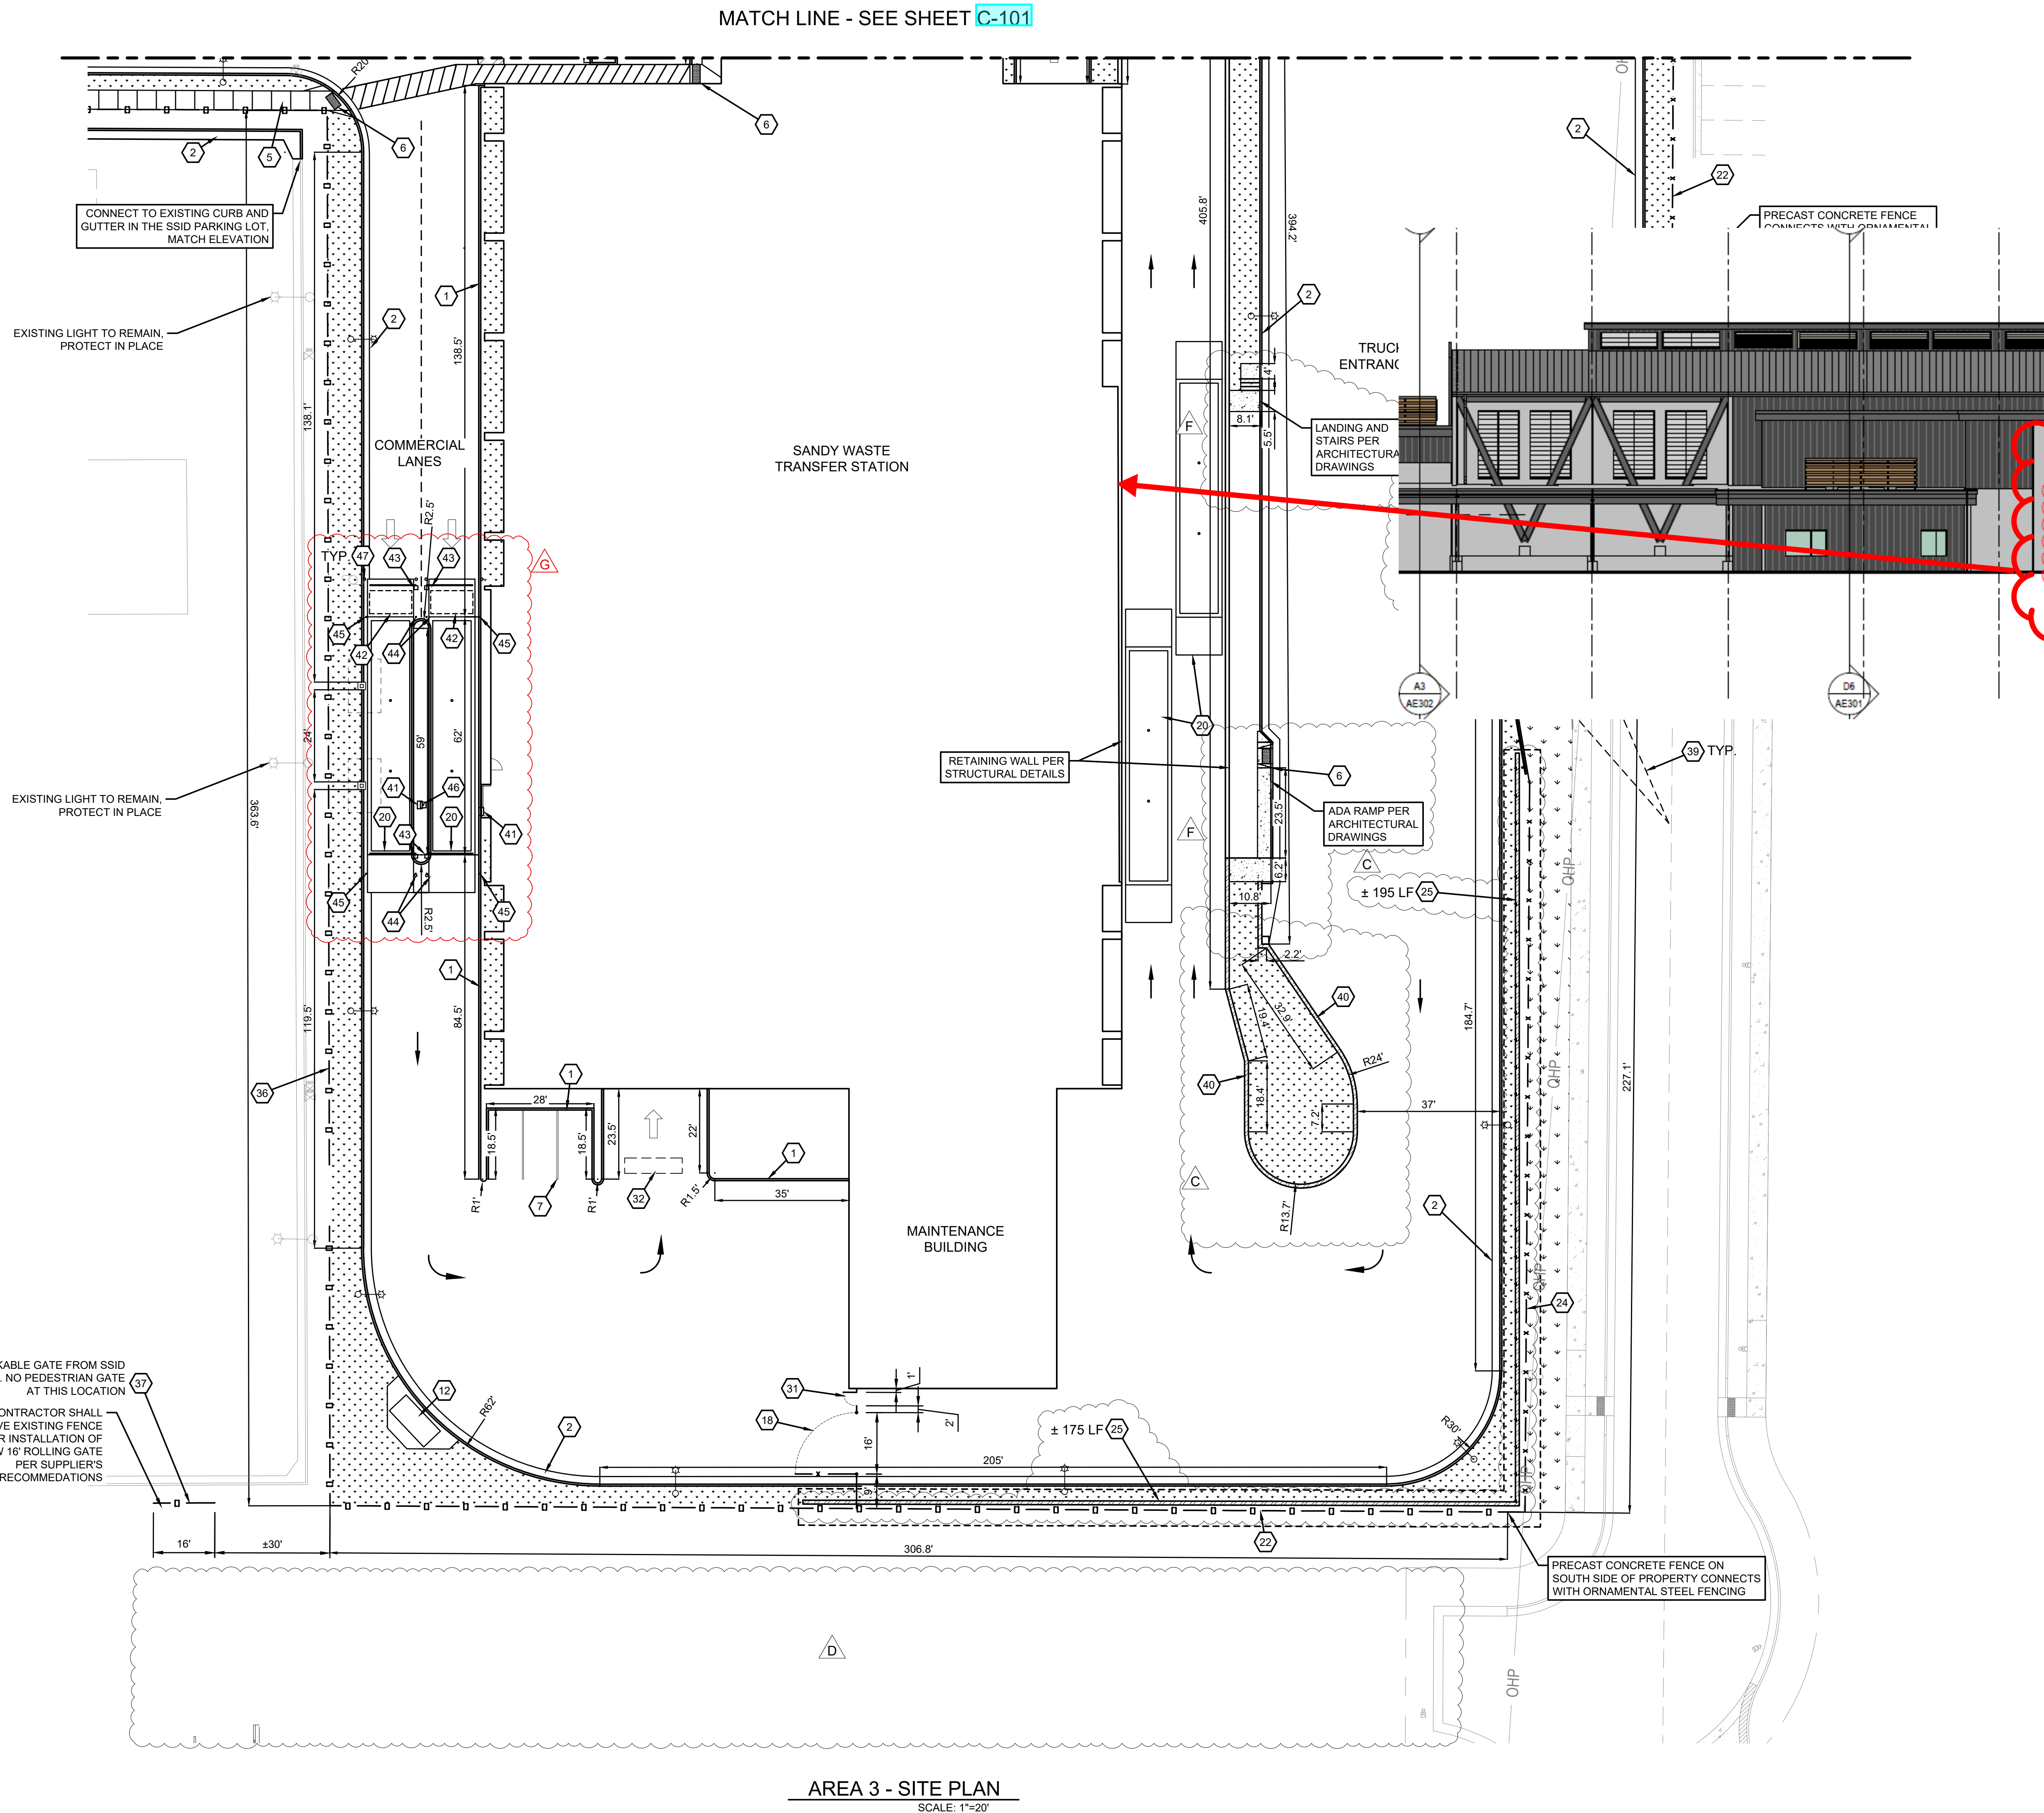

GENERAL NOTES:

1. ALL WORKS TO COMPLY WITH SANDY CITY STANDARDS AND SPECIFICATIONS.
2. ALL IMPROVEMENTS SHALL ADHERE TO ADA STANDARDS AND RECOMMENDATIONS.
3. DIMENSIONS ARE TO BACK OF CURB U.N.O.
4. CONTRACTOR SHALL REPAIR CURB, GUTTER, AND SIDEWALK ON THE SSID PROPERTY WHERE TYING IN NEW CONSTRUCTION.

KEYNOTES:

1. 6" CONCRETE CURB WALL, PER DETAIL **1/C-006** (SANDY CITY DETAIL CG-01).
2. 30" CONCRETE STANDARD CURB AND GUTTER, PER DETAIL **1/C-006** (SANDY CITY DETAIL CG-01).
3. CONCRETE WATERWAY PER DETAIL **3/C-006** (SANDY CITY DETAIL CG-03).
4. COMMERCIAL DRIVE APPROACH PER DETAIL **4/C-006** (SANDY CITY DETAIL DA-03).
5. 5' CONCRETE SIDEWALK, SEE DETAIL **4/C-009**.
6. ADA COMPLIANT DETECTABLE WARNING SURFACE PER DETAIL **3/C-009**, SAFETY YELLOW, CAST IN CONCRETE, FULL WIDTH OF RAMP.
7. 4" SOLID WHITE STRIPING.
8. 4" DASHED WHITE STRIPING.
9. PROPERTY BOUNDARY.
10. RELOCATE EXISTING LIGHTING APPROXIMATELY 7' SOUTH OF CURRENT LOCATION.
11. FILL WITH CONCRETE BETWEEN CURBING.
12. DIESEL FUELING STATION, EQUIPMENT AND TANK PROVIDED BY OWNER AND INSTALLED BY CONTRACTOR.
13. DUAL HEAD ELECTRIC CHARGING STATIONS, REF. ELECTRICAL DWGS.
14. CONCRETE GENERATOR PAD, SEE DETAIL **7/C-005**. LOCATE PAD TO MAINTAIN REQUIRED CLEARANCE PER MANUFACTURER'S RECOMMENDATIONS.
15. CONCRETE TRANSFORMER PAD, SEE DETAIL **5/C-005**. LOCATE PAD TO MAINTAIN REQUIRED CLEARANCE PER MANUFACTURER'S RECOMMENDATIONS.
16. 40' LONG x 6' TALL ELECTRIC OPERATED DOUBLE (20' EACH) SWING GATE, AMERISTAR TRANSPORT II, OR INSULATOR MOUNTAGE II, OR APPROVED EQUAL. GOOSENECK.
17. 20' LONG 6" TALL MANUAL DOUBLE SWING GATE, AMERISTAR MONTAGE II OR APPROVED EQUAL. INCLUDE HARDWARE AND LOCKS.
18. 25' LONG 6" TALL MANUAL SWING GATE, AMERISTAR MONTAGE II OR APPROVED EQUAL.
19. 32' LONG 6" TALL MANUAL DOUBLE SWING GATE, AMERISTAR MONTAGE II OR APPROVED EQUAL.
20. 36' LONG 6" TALL ELECTRIC OPERATED CANTILEVERED GATE, AMERISTAR TRANSPORT II OR EQUIVALENT. USE LIFTMASTER INSL24UL OPERATOR WITH ALL COMPONENTS NECESSARY FOR A COMPLETE AND OPERABLE SYSTEM, OR APPROVED EQUAL.
21. 26' LONG 6" TALL ELECTRIC OPERATED SWING GATE, AMERISTAR TRANSPORT II OR EQUIVALENT. USE LIFTMASTER INSL24UL OPERATOR WITH ALL COMPONENTS NECESSARY FOR A COMPLETE AND OPERABLE SYSTEM, OR APPROVED EQUAL.
22. 4' WIDE 6" TALL MANUAL PEDESTRIAN GATE, AMERISTAR MONTAGE II OR APPROVED EQUAL. INCLUDE HARDWARE AND GATE LOCK.
23. ROLLUP DOOR SENSOR IN DRIVEWAY. INSTALL PER MANUFACTURER'S RECOMMENDATIONS.
24. PAINT 5' WIDE CROSSWALK.
25. OUTBOUND GATE DOOR SENSOR PER MANUFACTURER'S RECOMMENDATIONS.
26. CUT CURB ON THE SSID PROPERTY FOR GATE.
27. 8' PRECAST CONCRETE WALL, OLYMPUS PRECAST STANDARD SHIPAL OR APPROVED EQUAL.
28. 16' LONG 6" TALL MANUAL ROLLING GATE, AMERISTAR MONTAGE II OR APPROVED EQUAL. COORDINATE FINAL GATE LOCATION WITH SSID ENGINEER, JARED OLDROYD AT JVO ENGINEERING, jared@jvoengineering.com, OR 801-828-7805. GATE SHALL BE EQUIPPED FOR FUTURE AUTOMATION AND SHALL INCLUDE GATE LOCK.
29. NOT USED.
30. 20'x60' CLEAR-VIEW TRIANGLE. NO OBSTACLES (INCLUDING VEGETATION) OVER THREE FEET HIGH, AS MEASURED FROM TOP BACK OF CURB, ARE ALLOWED WITHIN THE TRIANGLE.
31. FURNISH AND INSTALL HANDRAIL ON TOP OF RETAINING WALL, END HANDRAIL AT CANOPY.
32. UNATTENDED SCALE KIOSK, PROVIDED BY SOFTWARE SUPPLIER, INSTALLED BY CONTRACTOR. MOUNT KIOSK ON 4" SQUARE SHAPED STEEL POLE 10' TALL. MOUNTING HEIGHT SHALL BE FIELD COORDINATED WITH ENGINEER AND OWNER. LOCATE 12-FEET FROM FRONT OF SCALE AND 2-FEET FROM EDGE OF SCALE. PROVIDE (1) POWER CONDUIT TO ELECTRICAL SOURCE AND (1) COMMUNICATION CONDUIT FROM THE BUILDING NETWORK, WITH PULL STRINGS.
33. FURNISH AND INSTALL 36-50 IN GROUND LOOP SENSOR, CONNECT TO GATE CABINET.
34. LIFTMASTER VEHICLE ACCESS GATE, PROVIDED BY SOFTWARE SUPPLIER, INSTALLED BY CONTRACTOR. PROVIDE (1) POWER CONDUIT TO ELECTRICAL SOURCE AND (1) COMMUNICATION CONDUIT TO THE OPTO BOX WITH PULL STRINGS.
35. PHOTO EYES FOR VEHICLE ACCESS GATES, PROVIDED BY GATE SUPPLIER, INSTALLED BY CONTRACTOR. PROVIDE COMMUNICATION CONDUIT WITH PULL STRING FROM PHOTO EYE TO THE GATE CABINET. LOCATION PER THE SITE PLAN CAD FILE.
36. INSTALL REFLECTOR DIRECTLY ACROSS FROM THE PHOTO EYE, MOUNTED TO CONCRETE BOLLARD PER ARCHITECTURAL DETAIL.
37. OPTO BOX FOR ACCESS GATES, PROVIDED BY PARADIGM, INSTALLED BY CONTRACTOR. RUN POWER IN SAME CONDUIT AS KIOSK FROM THE POWER SOURCE. CONNECT TO NETWORK IN THE KIOSK WITH A NETWORK SWITCH. PROVIDE (1) CONDUIT TO ACCESS GATES FOR COMMUNICATIONS, WITH PULL STRINGS.
38. BOLLARDS PER ARCHITECTURAL DETAILS.

TRANS-JORDAN: SANDY WASTE TRANSFER STATION

8854 SOUTH PARKLAND DRIVE
SANDY, UT 84070

FA PROJECT # 05-21-0172

PROJECT #05-21-0172

CONSTRUCTION DOCUMENTS

| DATE | REVISION |
|----------|------------------|
| 1/20/22 | ADDENDUM 5 |
| 2/8/23 | PROJ1 |
| 4/15/23 | PROJ2 |
| 6/21/23 | PROJ2 |
| 9/8/23 | CONSBT UPDATES 1 |
| 12/23/23 | ASH-01 |
| 7/10/24 | SCALE UPDATES |

SITE PLAN
AREA 3

C-102

Galloway

FORSGREN
Associates, Inc.

577 South 200 East
Sandy, UT 84070
Tel: (801) 833-2100
Galloway/US.com

200 East 500 South, STE 200, Salt Lake City, UT 84143
PH: 801-364-4785 FAX: 801-364-4802

FRONT

17.1"

6"

8815

COLOR LEGEND

☐ WHITE VINYL
CONFIRM COLOR

NOTES

1. SIZING FOR LETTERS BASED ON "X". FONT SHOWN IS HELVETICA.
2. PLEASE CONFIRM ADDRESS PRIOR TO PRODUCTION.

DRAWINGS SCALE = NTS



2300 S. 3600 W. - SALT LAKE CITY, UT
TEL 801.973.7915 - FAX 801.973.0434
WWW.ALLOTECH.COM

PROJECT NAME

TRANS-JORDAN TRANSFER STATION
8815 SOUTH 700 WEST
SANDY UT 84070

GENERAL CONTRACTOR

BIG-D CONSTRUCTION
404 WEST 400 SOUTH
SALT LAKE CITY UT 84101

ARCHITECT

GALLOWAY
577 SOUTH 200 EAST
SALT LAKE CITY UT 84111



| DESCRIPTION OF CHANGES | SHOP DRAWINGS CREATED | SHOP DRAWINGS REVISED | | | | | |
|------------------------|-----------------------|-----------------------|----------|---------|-----|----------|--|
| BY | MDW | MDW | | | | | |
| DATE | 05/02/23 | 11/25/24 | | | | | |
| PROJECT# | 17881 | DATE | 05/02/23 | ARTWORK | MDW | REVIEWED | |

PAGE TOC/IDX.15

SHEET NO.

ADDRESS

VINYL ADDRESS
DRAWING / SPECIFICATION

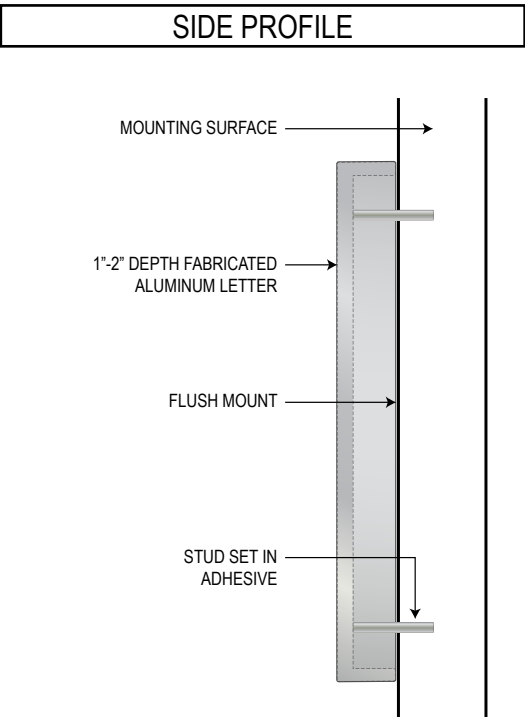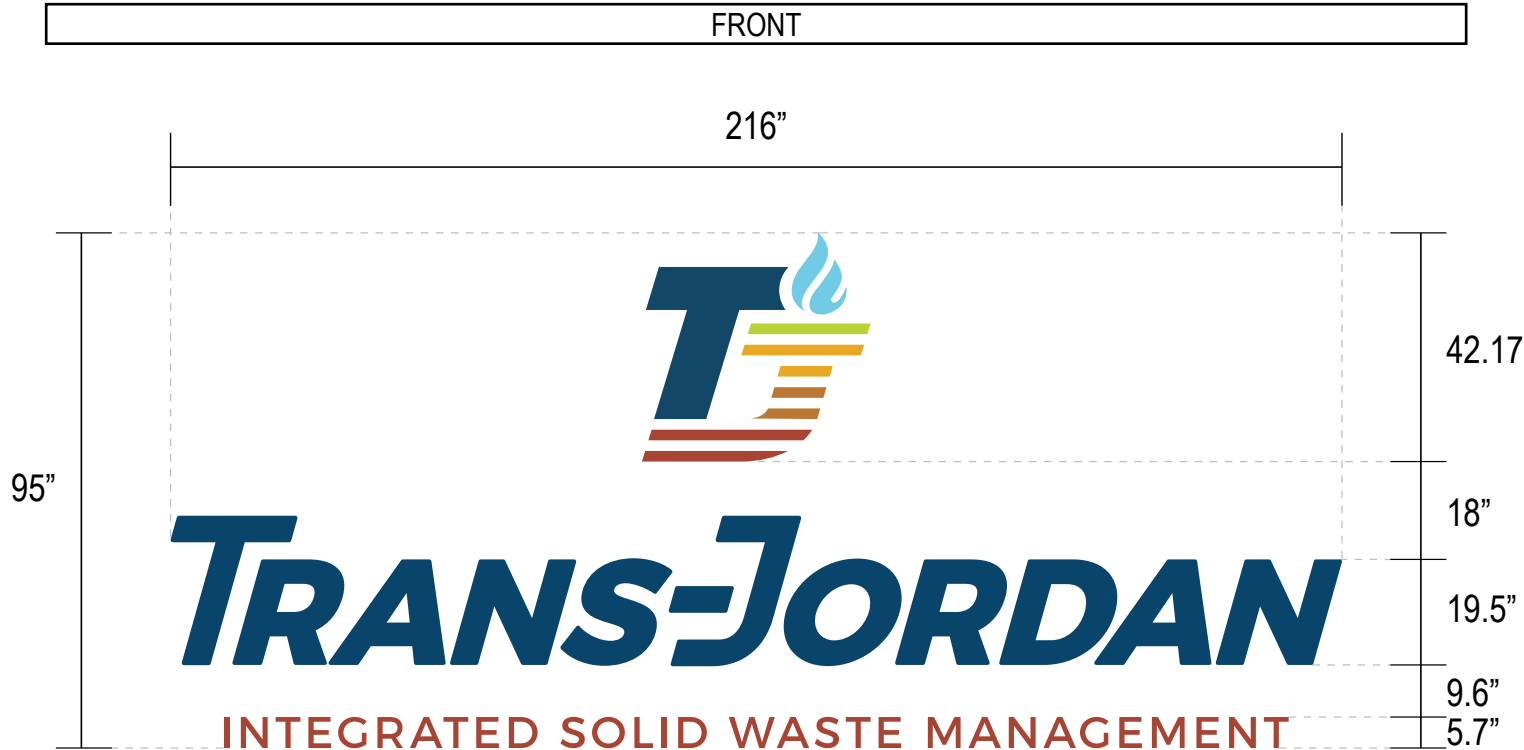

COLOR LEGEND

- ALUMINUM LETTERING
SW 9177 SALTY DOG
- ALUMINUM LETTERING & LOGO
SW 7599 BRICK PAVER
- ALUMINUM LOGO
SW 6953 CANDID BLUE
- ALUMINUM LOGO
SW 6642 RHUMBA ORANGE
- ALUMINUM LOGO
SW 6904 GUSTO GOLD
- ALUMINUM LOGO
SW 6920 CENTER STAGE

NOTES

1. SIZING FOR LETTERS BASED ON "X".
2. PLEASE CONFIRM SIZES, LAYOUT, ETC.
3. 1 SET OF LETTERING TOTAL.

DRAWINGS SCALE = NTS

ALLOTECH

2300 S. 3600 W. - SALT LAKE CITY, UT
TEL 801.973.7915 - FAX 801.973.0434
WWW.ALLOTECH.COM

PROJECT NAME

TRANS-JORDAN TRANSFER STATION
8815 SOUTH 700 WEST
SANDY UT 84070

GENERAL CONTRACTOR

BIG-D CONSTRUCTION
404 WEST 400 SOUTH
SALT LAKE CITY UT 84101

ARCHITECT

GALLOWAY
577 SOUTH 200 EAST
SALT LAKE CITY UT 84111

| DESCRIPTION OF CHANGES | SHOP DRAWINGS CREATED | SHOP DRAWINGS REVISED | | | | | |
|------------------------|-----------------------|-----------------------|----------|---------|-----|----------|--|
| BY | MDW | MDW | | | | | |
| DATE | 05/02/23 | 11/25/24 | | | | | |
| PROJECT# | 17881 | DATE | 05/02/23 | ARTWORK | MDW | REVIEWED | |


PAGE TOC/IDX.16

SHEET NO.

LETTERING

TRANSFER STATION LETTERING
DRAWING / SPECIFICATION

ELEVATION

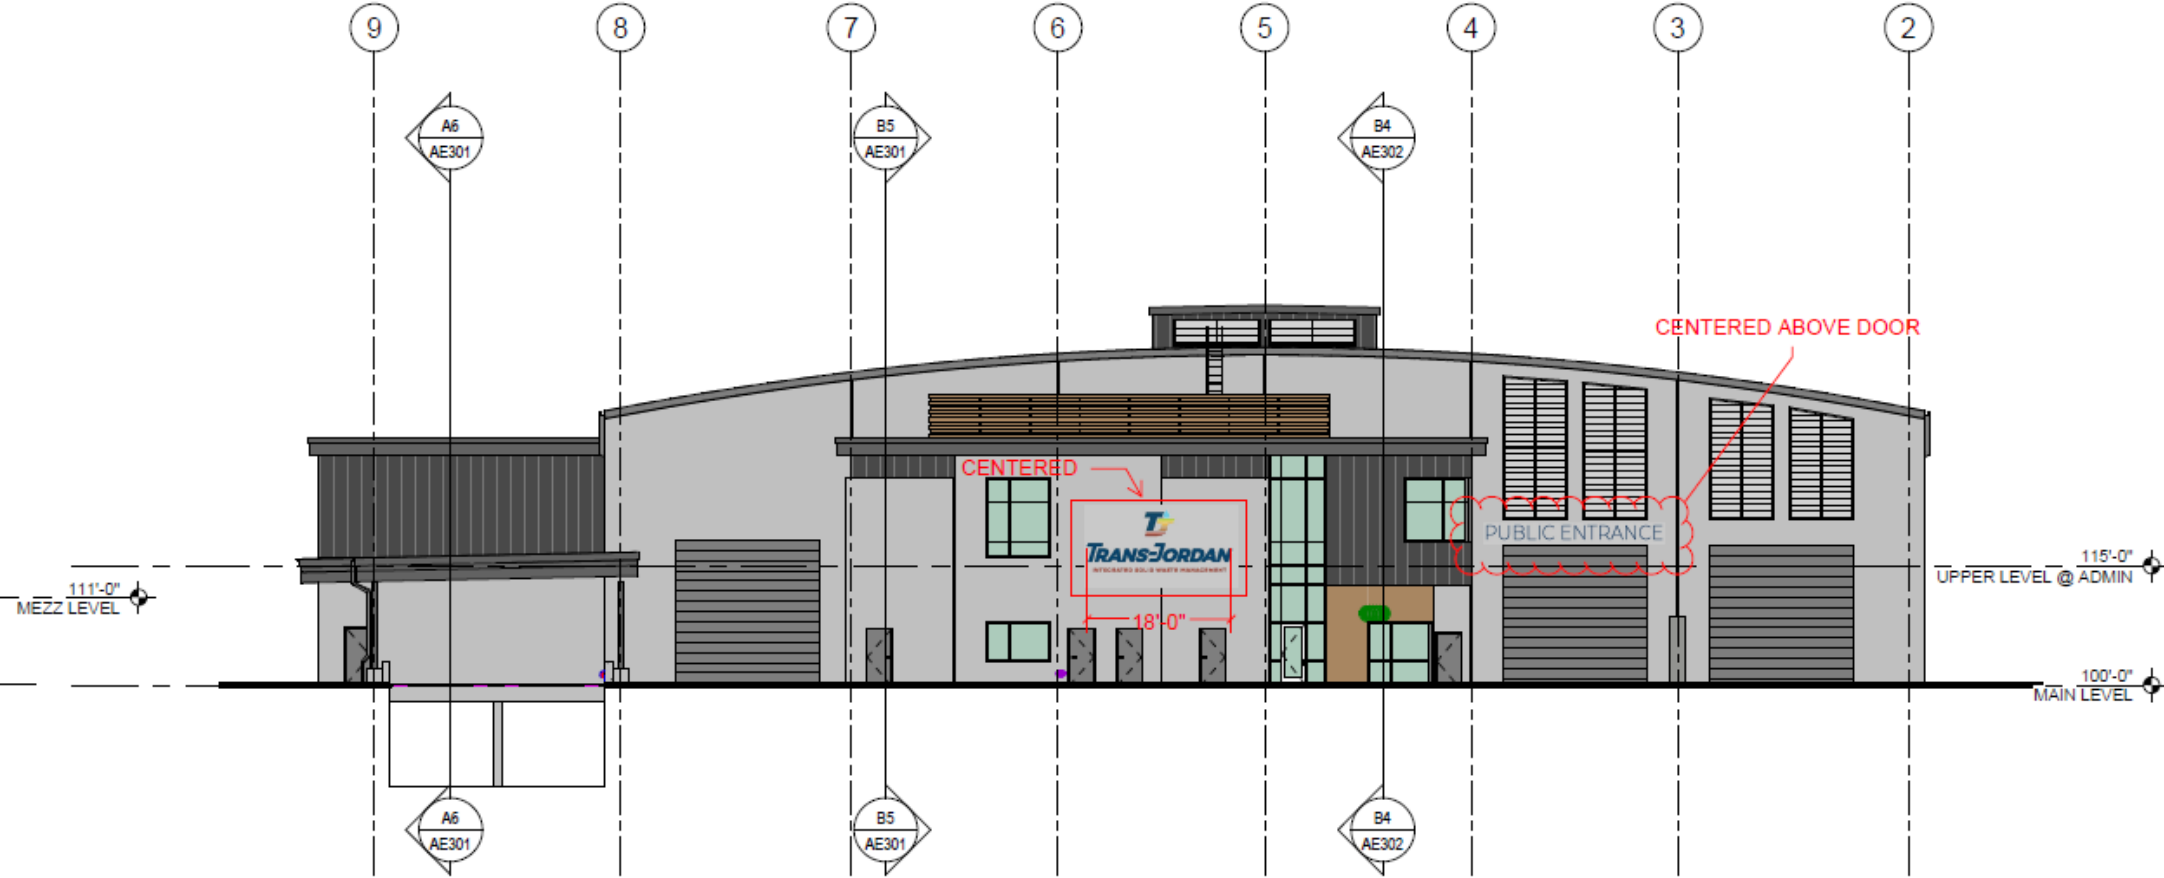

2300 S. 3600 W. - SALT LAKE CITY, UT
TEL 801.973.7915 - FAX 801.973.0434
WWW.ALLOTECH.COM

PROJECT NAME

TRANS-JORDAN TRANSFER STATION
8815 SOUTH 700 WEST
SANDY UT 84070

GENERAL CONTRACTOR

BIG-D CONSTRUCTION
404 WEST 400 SOUTH
SALT LAKE CITY UT 84101

ARCHITECT

GALLOWAY
577 SOUTH 200 EAST
SALT LAKE CITY UT 84111

| DESCRIPTION OF CHANGES | SHOP DRAWINGS CREATED | SHOP DRAWINGS REVISED | | | | | |
|------------------------|-----------------------|-----------------------|----------|---------|-----|----------|--|
| BY | MDW | MDW | | | | | |
| DATE | 05/02/23 | 11/25/24 | | | | | |
| PROJECT# | 17881 | DATE | 05/02/23 | ARTWORK | MDW | REVIEWED | |

PAGE TOC/IDX.17

SHEET NO.

ELEVATION

TRANSFER STATION

FRONT

271.8"

PUBLIC ENTRANCE

20"


COLOR LEGEND

ALUMINUM LETTERING
SW 9177 SALTY DOG
PLEASE CONFIRM

NOTES

1. SIZING FOR LETTERS BASED ON "X". FONT SHOWN IS MONTERRAT REGULAR- PLEASE CONFIRM.
2. PLEASE CONFIRM SIZES, LAYOUT, ETC.
3. 1 SET OF LETTERING TOTAL.

SIDE PROFILE

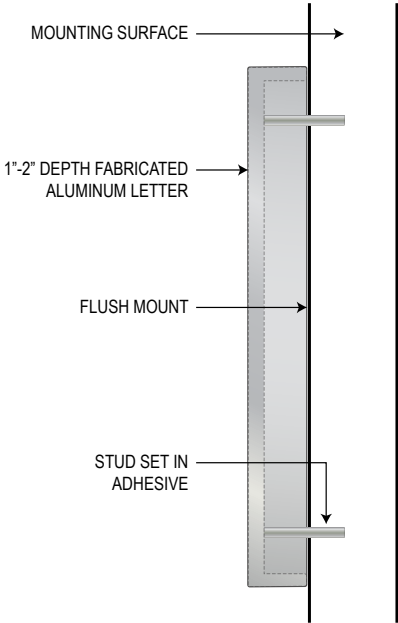

DRAWINGS SCALE = NTS



2300 S. 3600 W. - SALT LAKE CITY, UT
TEL 801.973.7915 - FAX 801.973.0434
WWW.ALLOTECH.COM

PROJECT NAME

TRANS-JORDAN TRANSFER STATION
8815 SOUTH 700 WEST
SANDY UT 84070

GENERAL CONTRACTOR

BIG-D CONSTRUCTION
404 WEST 400 SOUTH
SALT LAKE CITY UT 84101

ARCHITECT

GALLOWAY
577 SOUTH 200 EAST
SALT LAKE CITY UT 84111

| DESCRIPTION OF CHANGES | SHOP DRAWINGS CREATED | SHOP DRAWINGS REVISED | | | | | |
|------------------------|-----------------------|-----------------------|----------|---------|-----|----------|--|
| BY | MDW | MDW | | | | | |
| DATE | 05/02/23 | 11/25/24 | | | | | |
| PROJECT# | 17881 | DATE | 05/02/23 | ARTWORK | MDW | REVIEWED | |


PAGE TOC/IDX.18

SHEET NO.

LETTERING

PUBLIC ENTRANCE LETTERING
DRAWING / SPECIFICATION

ELEVATION

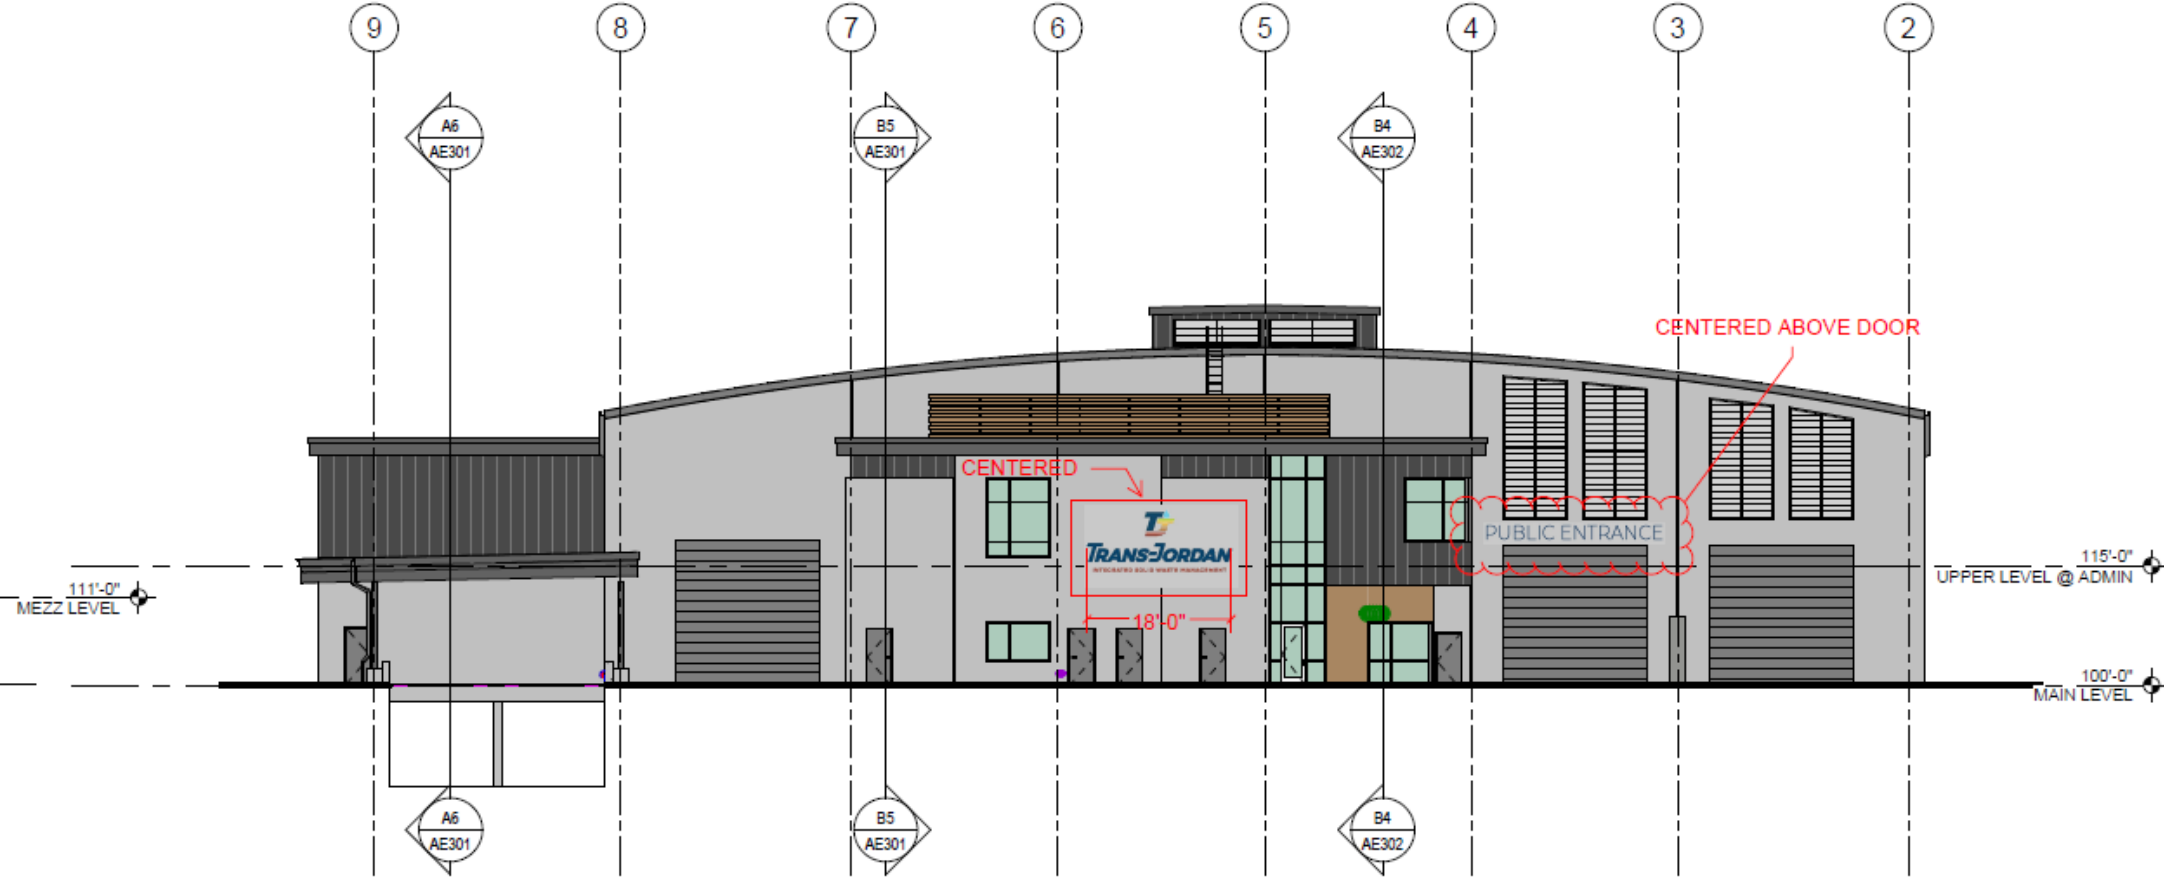

2300 S. 3600 W. - SALT LAKE CITY, UT
TEL 801.973.7915 - FAX 801.973.0434
WWW.ALLOTECH.COM

PROJECT NAME

TRANS-JORDAN TRANSFER STATION
8815 SOUTH 700 WEST
SANDY UT 84070

GENERAL CONTRACTOR

BIG-D CONSTRUCTION
404 WEST 400 SOUTH
SALT LAKE CITY UT 84101

ARCHITECT

GALLOWAY
577 SOUTH 200 EAST
SALT LAKE CITY UT 84111



| DESCRIPTION OF CHANGES | SHOP DRAWINGS CREATED | SHOP DRAWINGS REVISED | | | | | |
|------------------------|-----------------------|-----------------------|----------|---------|-----|----------|--|
| BY | MDW | MDW | | | | | |
| DATE | 05/02/23 | 11/25/24 | | | | | |
| PROJECT# | 17881 | DATE | 05/02/23 | ARTWORK | MDW | REVIEWED | |

PAGE TOC/IDX.19

SHEET NO.

ELEVATION

PUBLIC ENTRANCE

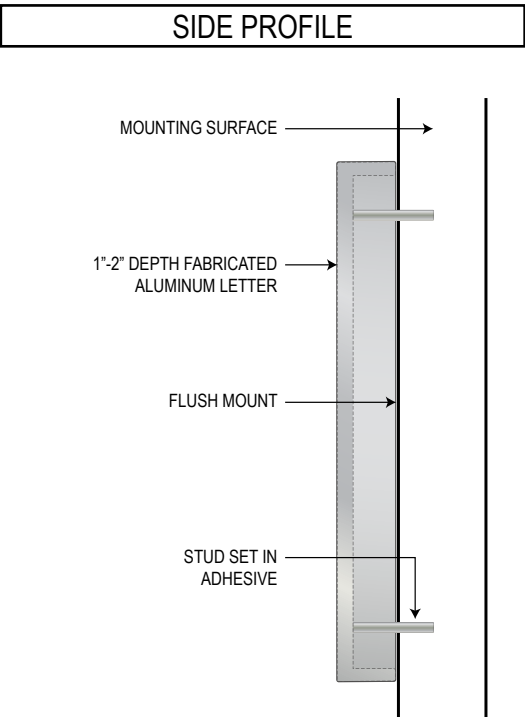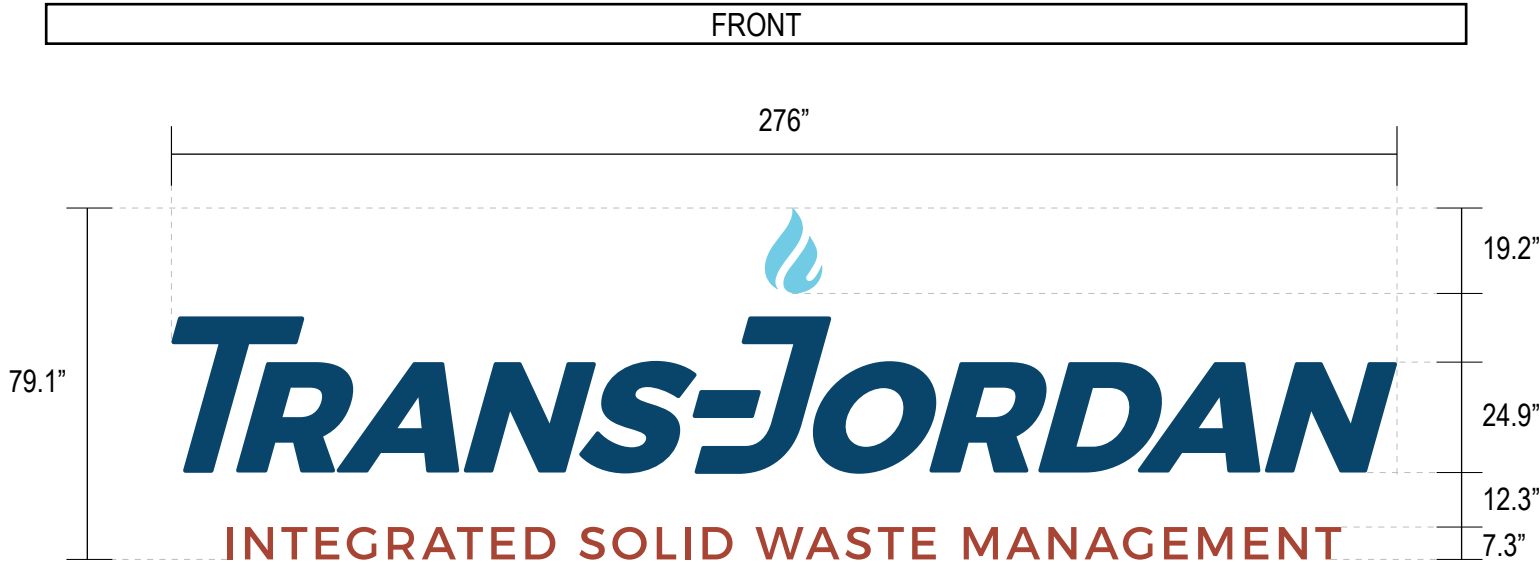

COLOR LEGEND

- ALUMINUM LETTERING
SW 9177 SALTY DOG
- ALUMINUM LETTERING & LOGO
SW 7599 BRICK PAVER
- ALUMINUM LOGO
SW 6953 CANDID BLUE

NOTES

1. SIZING FOR LETTERS BASED ON "X".
2. PLEASE CONFIRM SIZES, LAYOUT, ETC.
3. 1 SET OF LETTERING TOTAL.

DRAWINGS SCALE = NTS

2300 S. 3600 W. - SALT LAKE CITY, UT
TEL 801.973.7915 - FAX 801.973.0434
WWW.ALLOTECH.COM

PROJECT NAME

TRANS-JORDAN TRANSFER STATION
8815 SOUTH 700 WEST
SANDY UT 84070

GENERAL CONTRACTOR

BIG-D CONSTRUCTION
404 WEST 400 SOUTH
SALT LAKE CITY UT 84101

ARCHITECT

GALLOWAY
577 SOUTH 200 EAST
SALT LAKE CITY UT 84111

| DESCRIPTION OF CHANGES | SHOP DRAWINGS CREATED | SHOP DRAWINGS REVISED | | | | | |
|------------------------|-----------------------|-----------------------|----------|---------|-----|----------|--|
| BY | MDW | MDW | | | | | |
| DATE | 05/02/23 | 11/25/24 | | | | | |
| PROJECT# | 17881 | DATE | 05/02/23 | ARTWORK | MDW | REVIEWED | |


PAGE TOC/IDX.20

SHEET NO.

LETTERING

TRANSFER STATION LETTERING
DRAWING / SPECIFICATION

ELEVATION

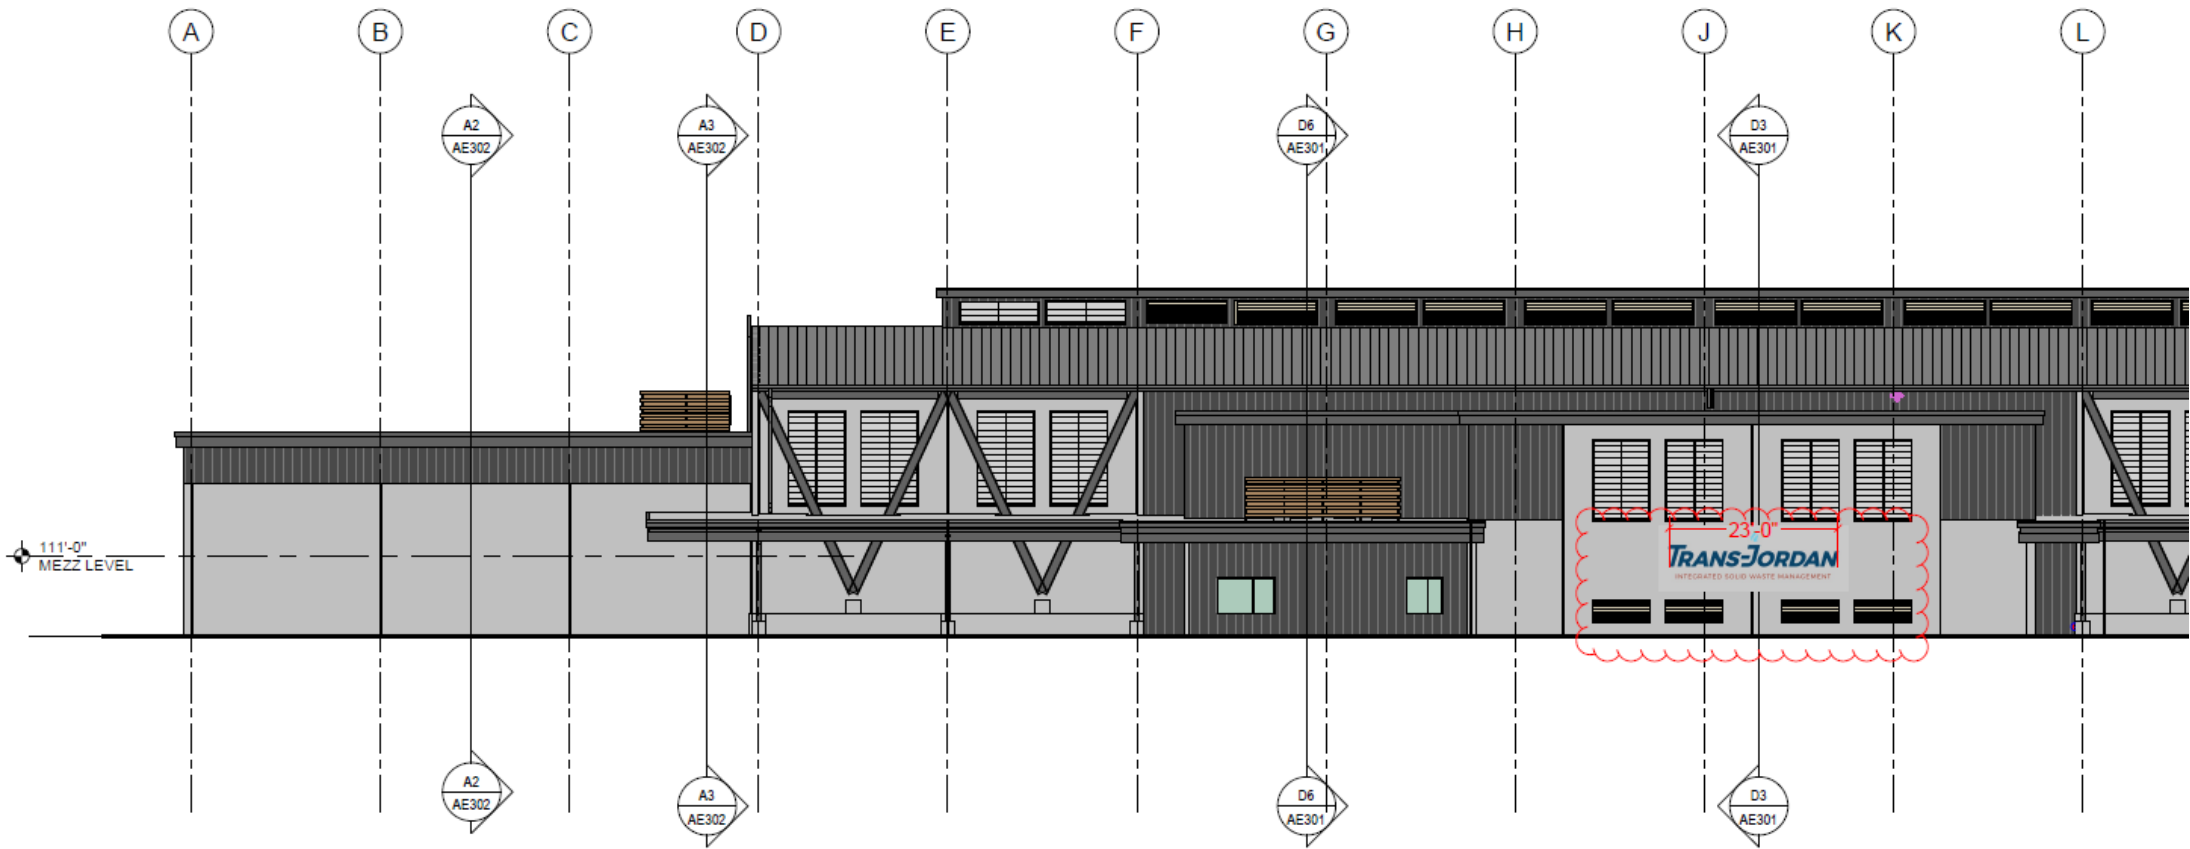

A6 OVERALL EAST ELEVATION
AE201 SCALE 1/16" = 1'-0"

ALLOTECH
2300 S. 3600 W. - SALT LAKE CITY, UT
TEL 801.973.7915 - FAX 801.973.0434
WWW.ALLOTECH.COM

PROJECT NAME
TRANS-JORDAN TRANSFER STATION
8815 SOUTH 700 WEST
SANDY UT 84070

GENERAL CONTRACTOR
BIG-D CONSTRUCTION
404 WEST 400 SOUTH
SALT LAKE CITY UT 84101

ARCHITECT
GALLOWAY
577 SOUTH 200 EAST
SALT LAKE CITY UT 84111


| DESCRIPTION OF CHANGES | SHOP DRAWINGS CREATED | SHOP DRAWINGS REVISED | | | | |
|------------------------|-----------------------|-----------------------|----------|---------|-----|----------|
| BY | MDW | MDW | | | | |
| DATE | 05/02/23 | 11/25/24 | | | | |
| PROJECT# | 17881 | DATE | 05/02/23 | ARTWORK | MDW | REVIEWED |

PAGE TOC/IDX.21

SHEET NO.

ELEVATION

TRANSFER STATION

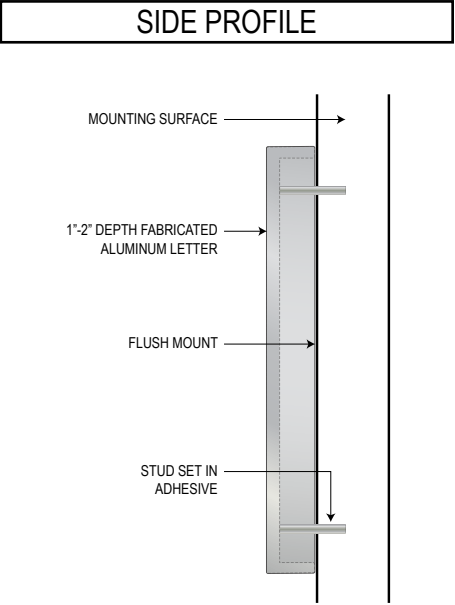

COLOR LEGEND

| |
|--|
| ALUMINUM LETTERING SW 9177 SALTY DOG |
| ALUMINUM LETTERING & LOGO SW 7599 BRICK PAVER |
| ALUMINUM LOGO SW 6953 CANDID BLUE |
| ALUMINUM LOGO SW 6642 RHUMBA ORANGE |
| ALUMINUM LOGO SW 6904 GUSTO GOLD |
| ALUMINUM LOGO SW 6920 CENTER STAGE |

- NOTES
- 1. SIZING FOR LETTERS BASED ON "X".
 - 2. PLEASE CONFIRM SIZES, LAYOUT, ETC.
 - 3. 1 SET OF LETTERING TOTAL.
 - 4. SMALLER LETTERS MAY BE TOO SMALL TO FABRICATE AND CHANGE TO ANOTHER CONSTRUCTION, PLEASE ADVISE.



2300 S. 3600 W. - SALT LAKE CITY, UT
TEL 801.973.7915 - FAX 801.973.0434
WWW.ALLOTECH.COM

PROJECT NAME
TRANS-JORDAN TRANSFER STATION
8815 SOUTH 700 WEST
SANDY UT 84070

GENERAL CONTRACTOR
BIG-D CONSTRUCTION
404 WEST 400 SOUTH
SALT LAKE CITY UT 84101

ARCHITECT
GALLOWAY
577 SOUTH 200 EAST
SALT LAKE CITY UT 84111

| DESCRIPTION OF CHANGES | SHOP DRAWINGS CREATED | SHOP DRAWINGS REVISED | | | | | |
|------------------------|-----------------------|-----------------------|----------|---------|-----|----------|--|
| BY | MDW | MDW | | | | | |
| DATE | 05/02/23 | 11/25/24 | | | | | |
| PROJECT# | 17881 | DATE | 05/02/23 | ARTWORK | MDW | REVIEWED | |


PAGE TOC/IDX.22

SHEET NO.

LETTERING

SCALE HOUSE LETTERING
DRAWING / SPECIFICATION

ELEVATION

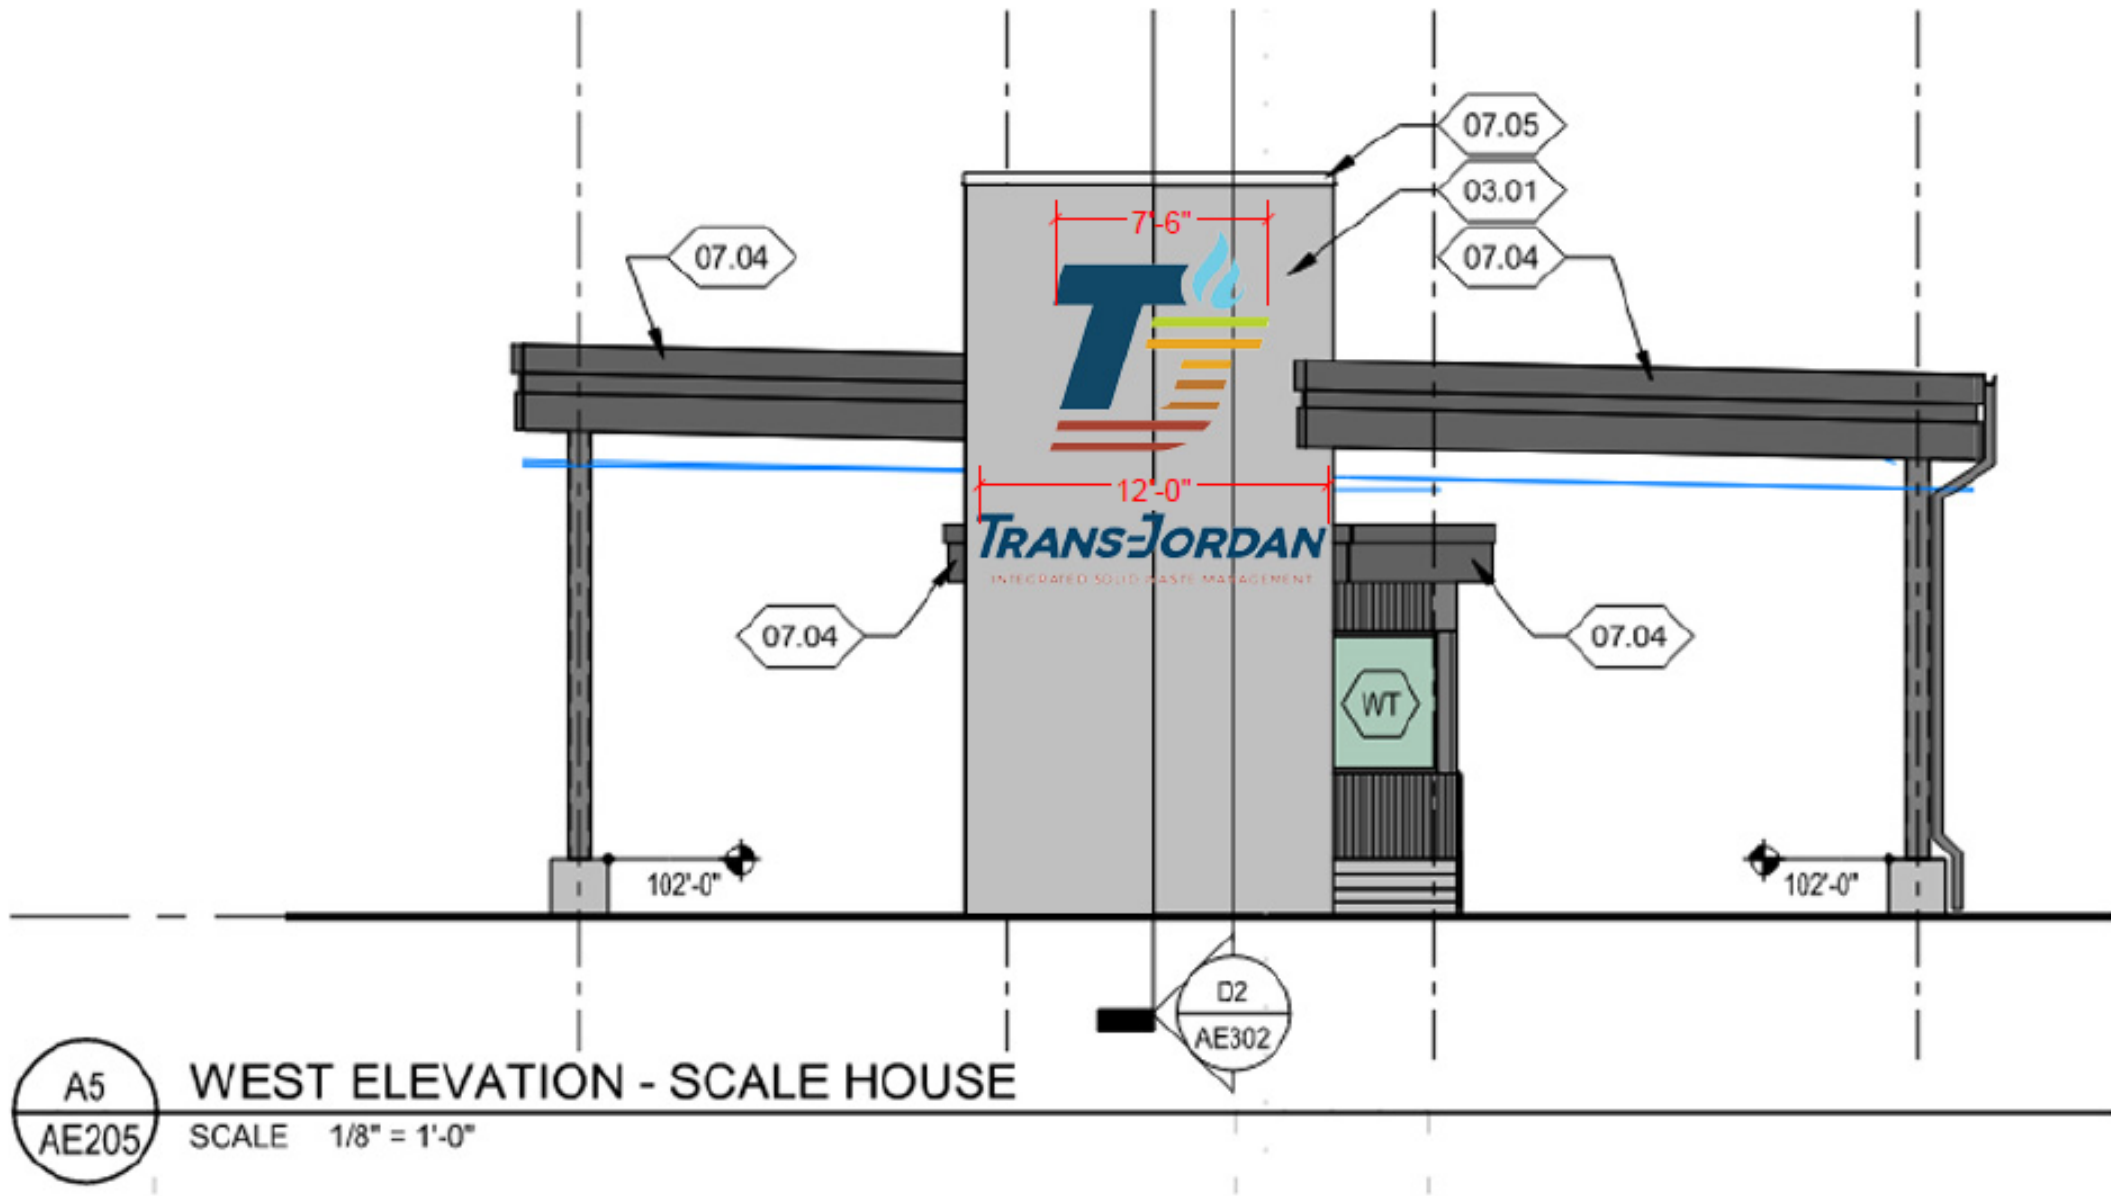

2300 S. 3600 W. - SALT LAKE CITY, UT
TEL 801.973.7915 - FAX 801.973.0434
WWW.ALLOTECH.COM

PROJECT NAME

TRANS-JORDAN TRANSFER STATION
8815 SOUTH 700 WEST
SANDY UT 84070

GENERAL CONTRACTOR

BIG-D CONSTRUCTION
404 WEST 400 SOUTH
SALT LAKE CITY UT 84101

ARCHITECT

GALLOWAY
577 SOUTH 200 EAST
SALT LAKE CITY UT 84111

| DESCRIPTION OF CHANGES | SHOP DRAWINGS CREATED | SHOP DRAWINGS REVISED | | | | |
|------------------------|-----------------------|-----------------------|--|--|--|--|
| BY | MDW | MDW | | | | |
| DATE | 05/02/23 | 11/25/24 | | | | |
| PROJECT# | 17881 | | | | | |
| DATE | 05/02/23 | | | | | |
| ARTWORK | MDW | | | | | |
| REVIEWED | | | | | | |

PAGE TOC/IDX.23

SHEET NO.

ELEVATION

SCALE HOUSE

RGB Multi Color Scrolling LED Sign



2236 S 3270 W Unit 1
Salt Lake City, UT 84119
(801) 972-5101
www.impact-signs.com

Copyright © 2025
This drawing is provided for the purpose of illustrating the proposed project. Unauthorized use, copying, scanning or sharing is strictly prohibited & protected by law. Customer is responsible for providing electrical service to sign. Impact Signs will not be held liable for any underground damage during excavations. Colors depicted may not match actual colors on finished product.

This drawing is property of
IMPACT SIGNS
All rights reserved.



ORIGIN DATE: 2-5-25

REVISIONS
01:

CUSTOMER
GALLOWAY ARCHITECTS
8815 SOUTH 700 WEST
SANDY, UTAH
84070

Sales: BRAD
Designer: GERI CORDOVA
PROJECT


250224-02

<Bracket Detail>


1" (Height)

1-3/8" (Width)

2.75"

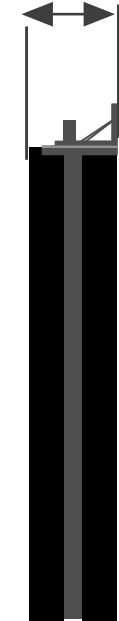

Side View

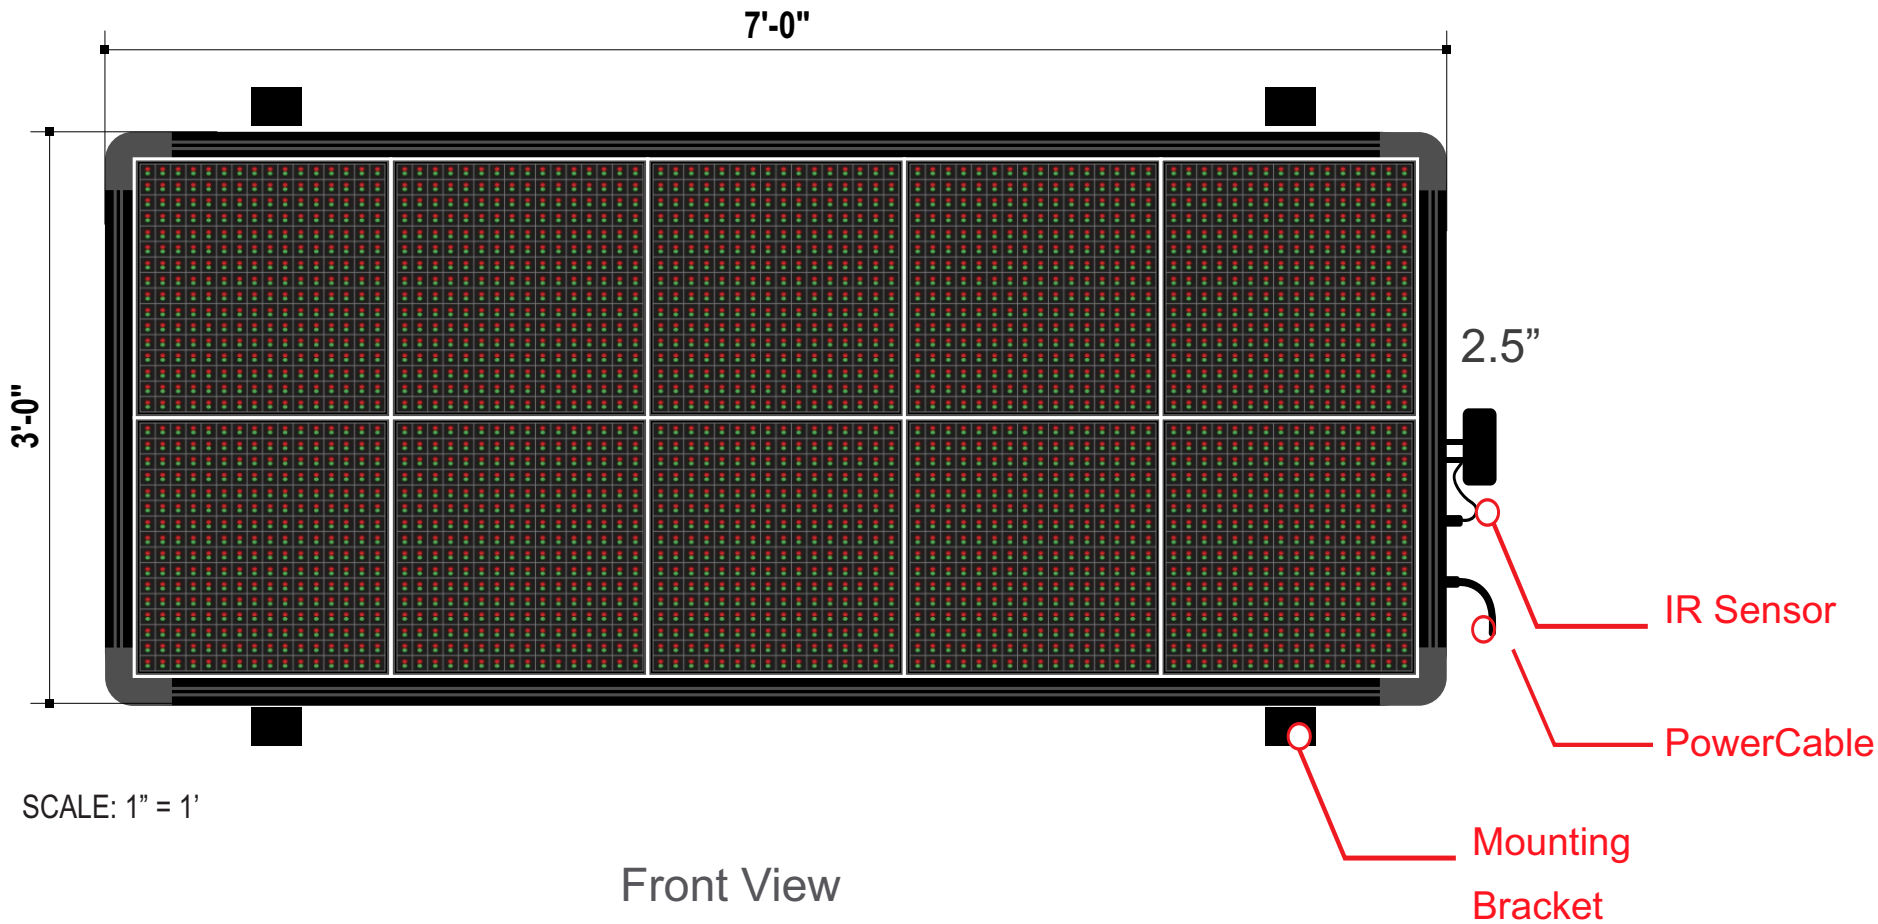

SCALE: 1" = 1'

Front View

| Frame Size | Weight | Pixel Matrix |
|------------|---------|--------------|
| 85" x 36" | 60 lbs. | 32 x 80 |

Copyright © 2025

This drawing is provided for the purpose of illustrating the proposed project. Unauthorized use, copying, scanning or sharing is strictly prohibited & protected by law. Customer is responsible for providing electrical service to sign. Impact Signs will not be held liable for any underground damage during excavations. Colors depicted may not match actual colors on finished product.

This drawing is property of
IMPACT SIGNS
All rights reserved.



ORIGIN DATE: 2-5-25

REVISIONS

CUSTOMER

GALLOWAY ARCHITECTS
8815 SOUTH 700 WEST
SANDY, UTAH
84070

Sales: BRAD

Designer: GERI CORDOVA

PROJECT

250224-02

3 of 1

